


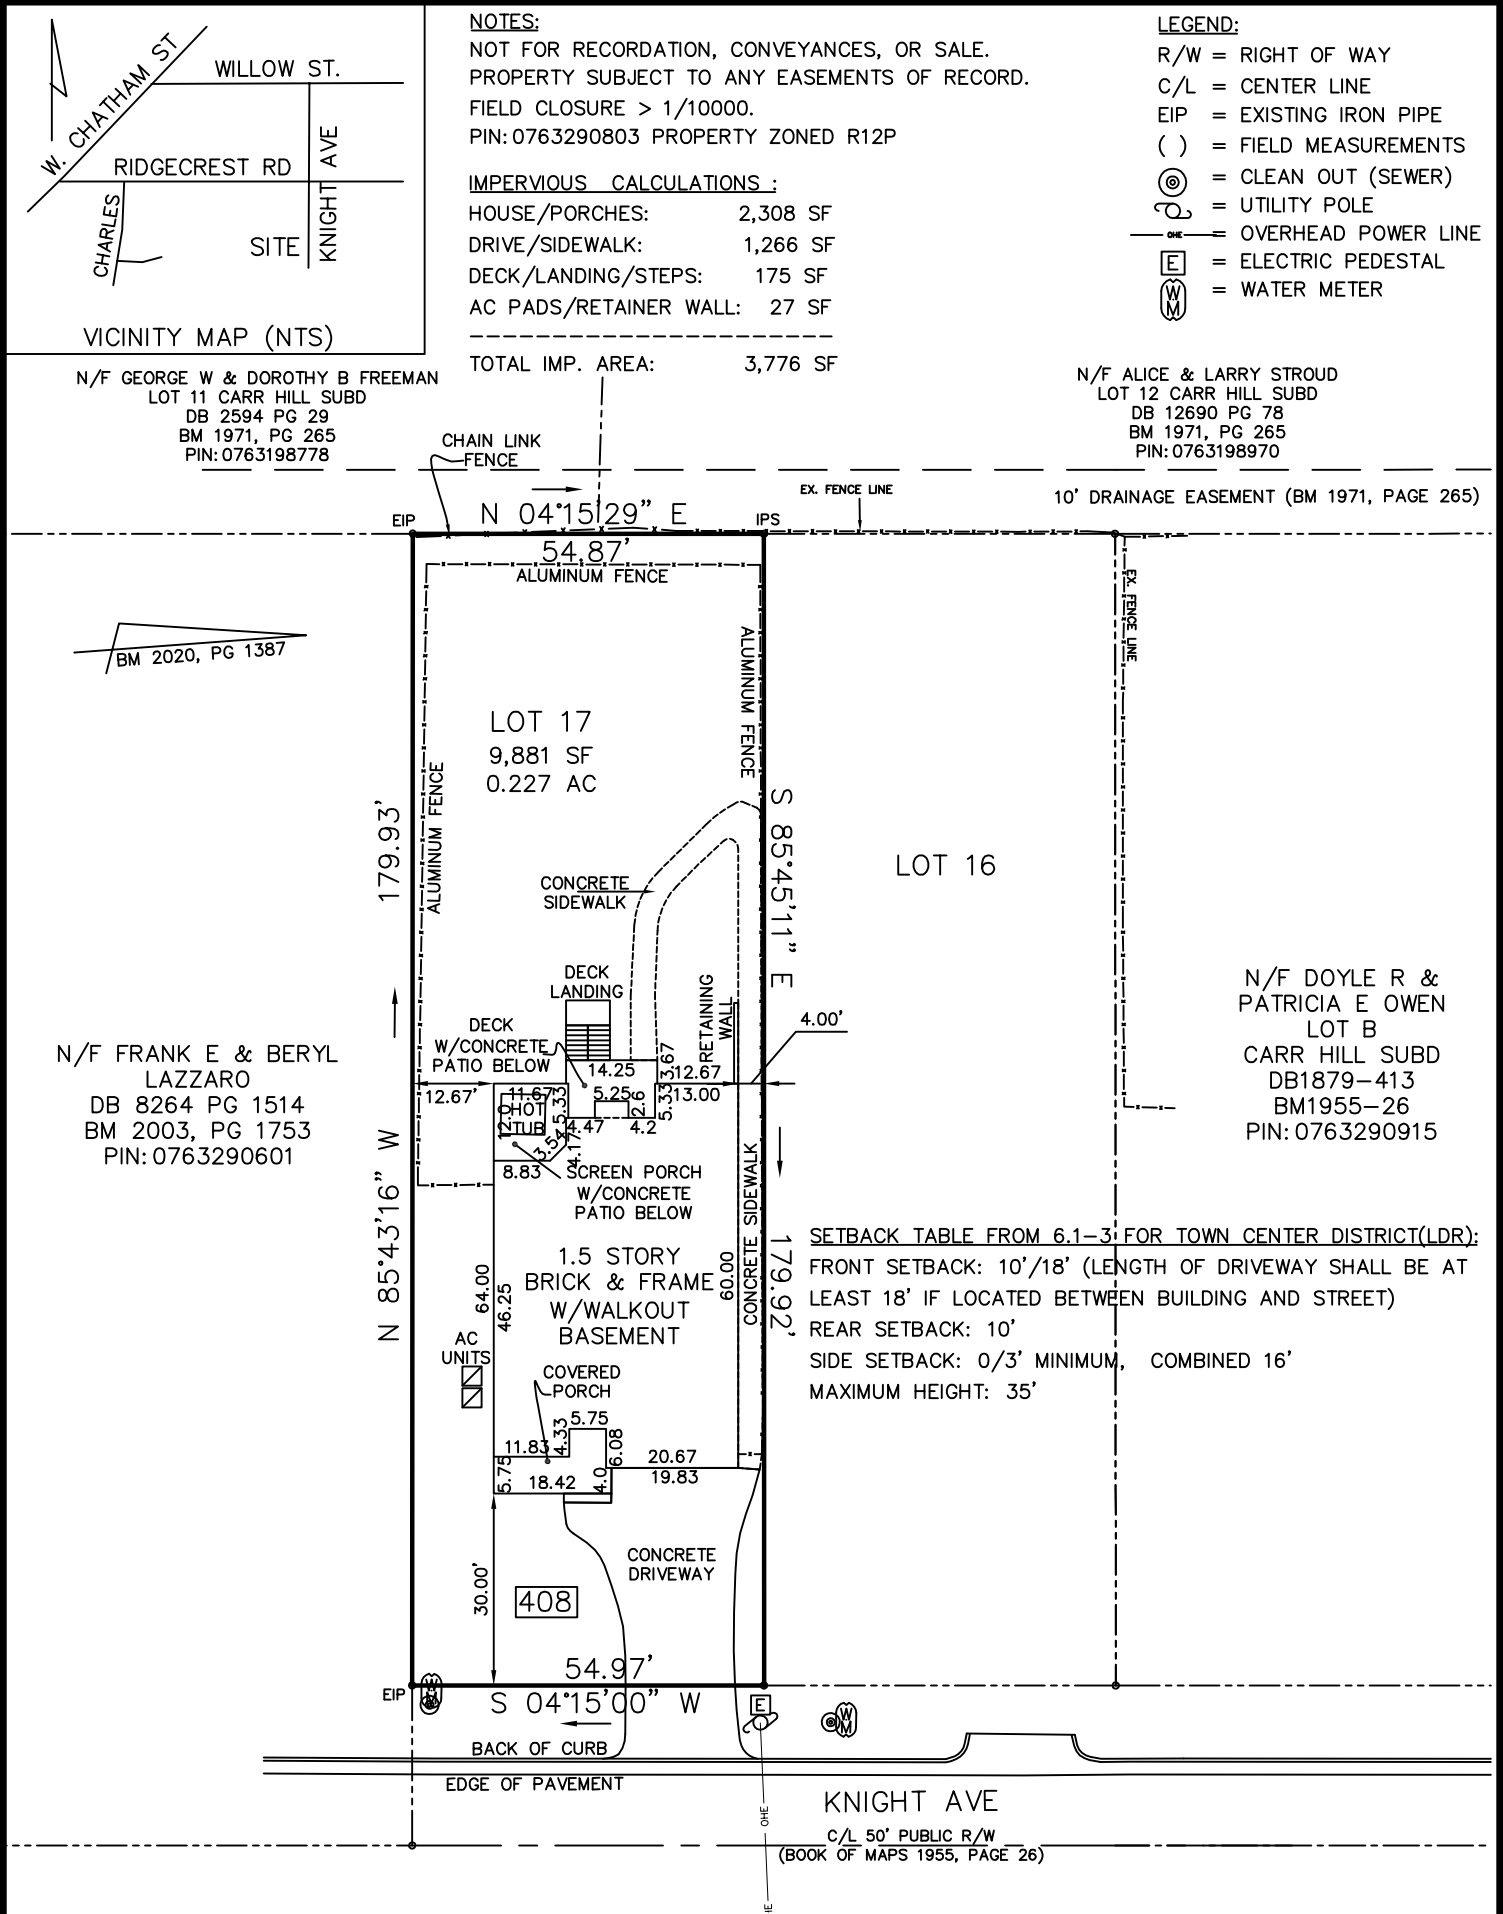

THIS PROPERTY IS (IS NOT) LOCATED IN AN AREA DESIGNATED AS HAVING SPECIAL FLOOD HAZARDS ACCORDING TO FLOOD INSURANCE RATE MAP #3720076300 J . EFFECTIVE DATE: MAY 2, 2006.

LOT 17 BLOCK _____ SECTION _____
SUBDIVISION EXEMPT PLAT NORTH PART OF LOTS 16 & 17 CARR HILLS
RECORDED IN BOOK OF MAPS 2020 PAGE 1387 WAKE COUNTY REGISTRY

AS-BUILT
SAW/MW
2019248

I, SONYA A WARD, HEREBY CERTIFY THAT THIS MAP IS CORRECT, THAT THE BUILDINGS ARE WHOLLY ON THE LOT, AND THAT THERE ARE NO ENCROACHMENTS OF OTHER BUILDINGS ON THE SAID LOT EXCEPT AS SHOWN ON SURVEY.

WARD SURVEYING SERVICES, PLLC
LAND SURVEYING & PLANNING
APEX, N.C. (919) 367-7858

SURVEY FOR:
REWARD BUILDERS, INC.

TOWN OF CARY WAKE COUNTY NC

SCALE: 1"=30'

DATE: 07/20/2021

BOOK #: 313p58

L-4017